

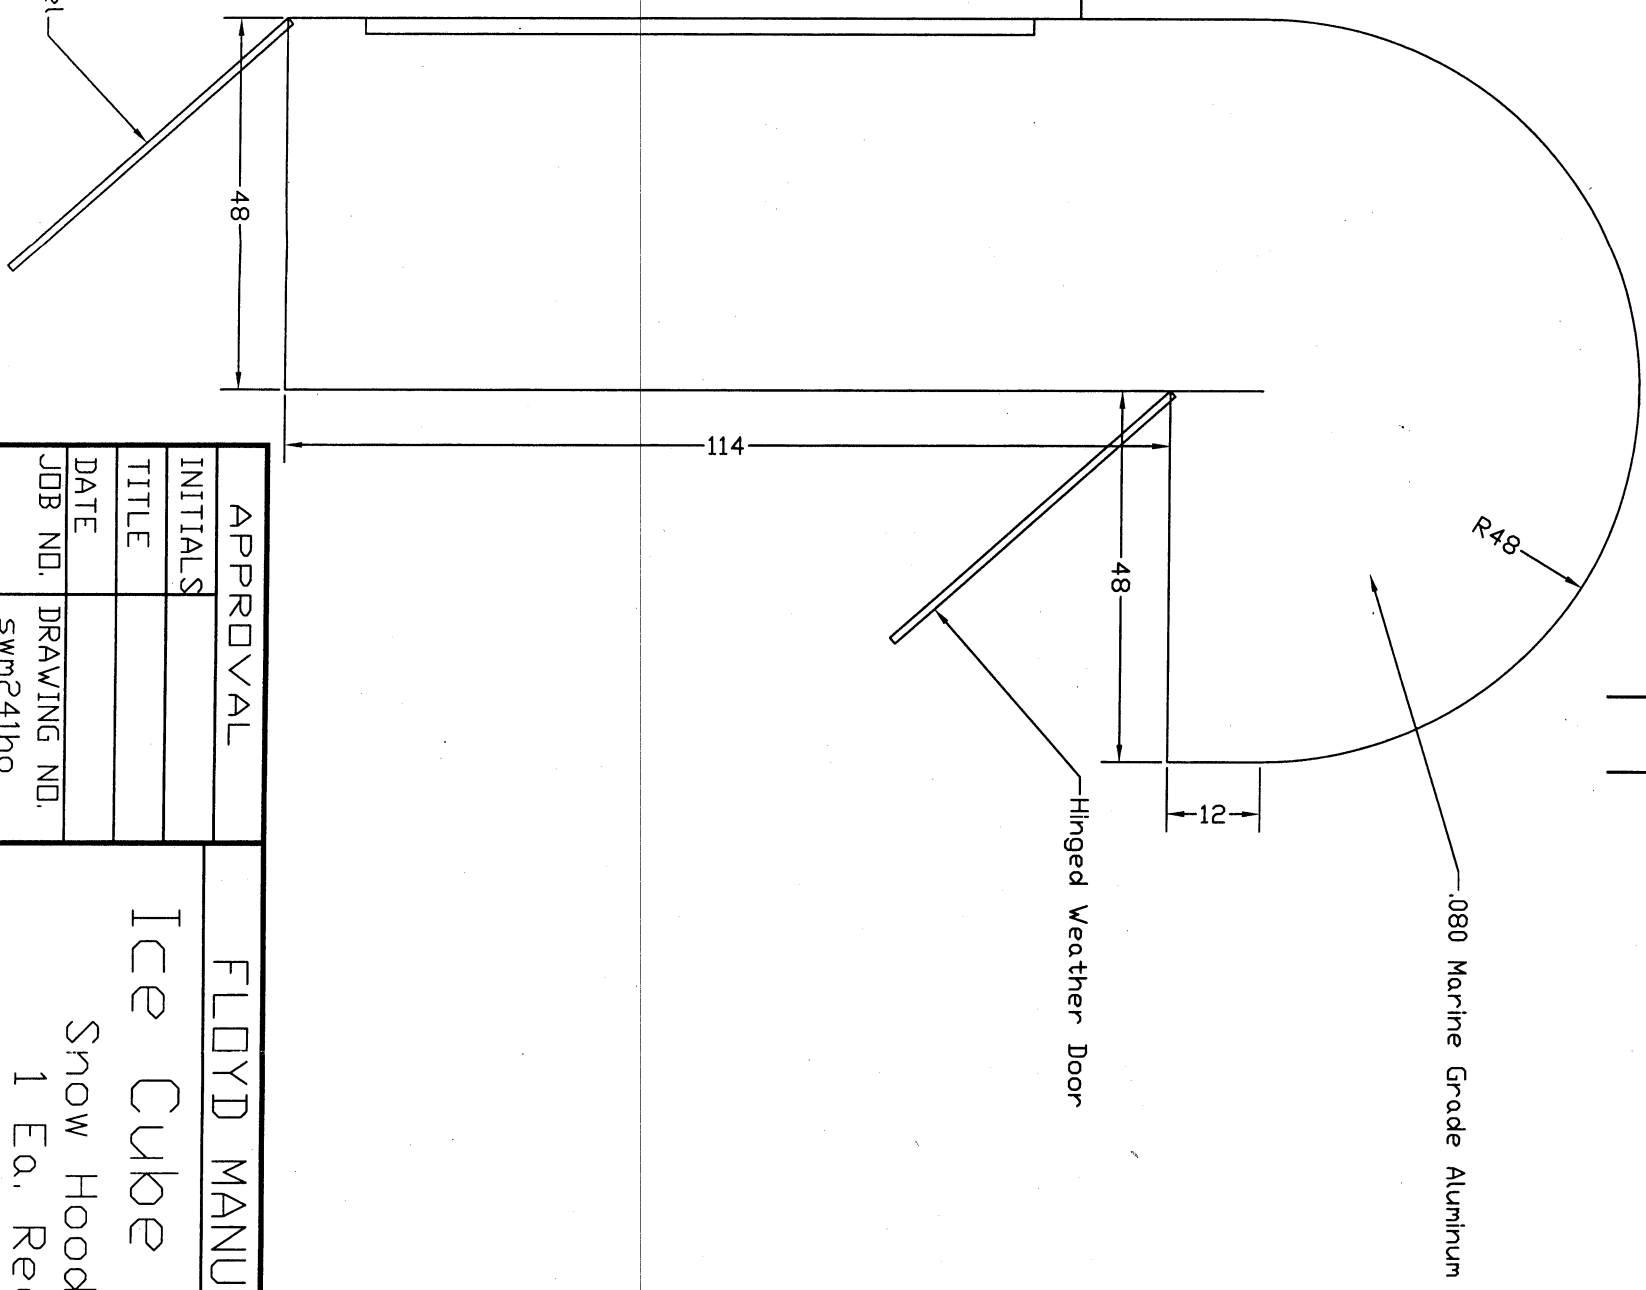


Markups by BMB,
8.26.2020

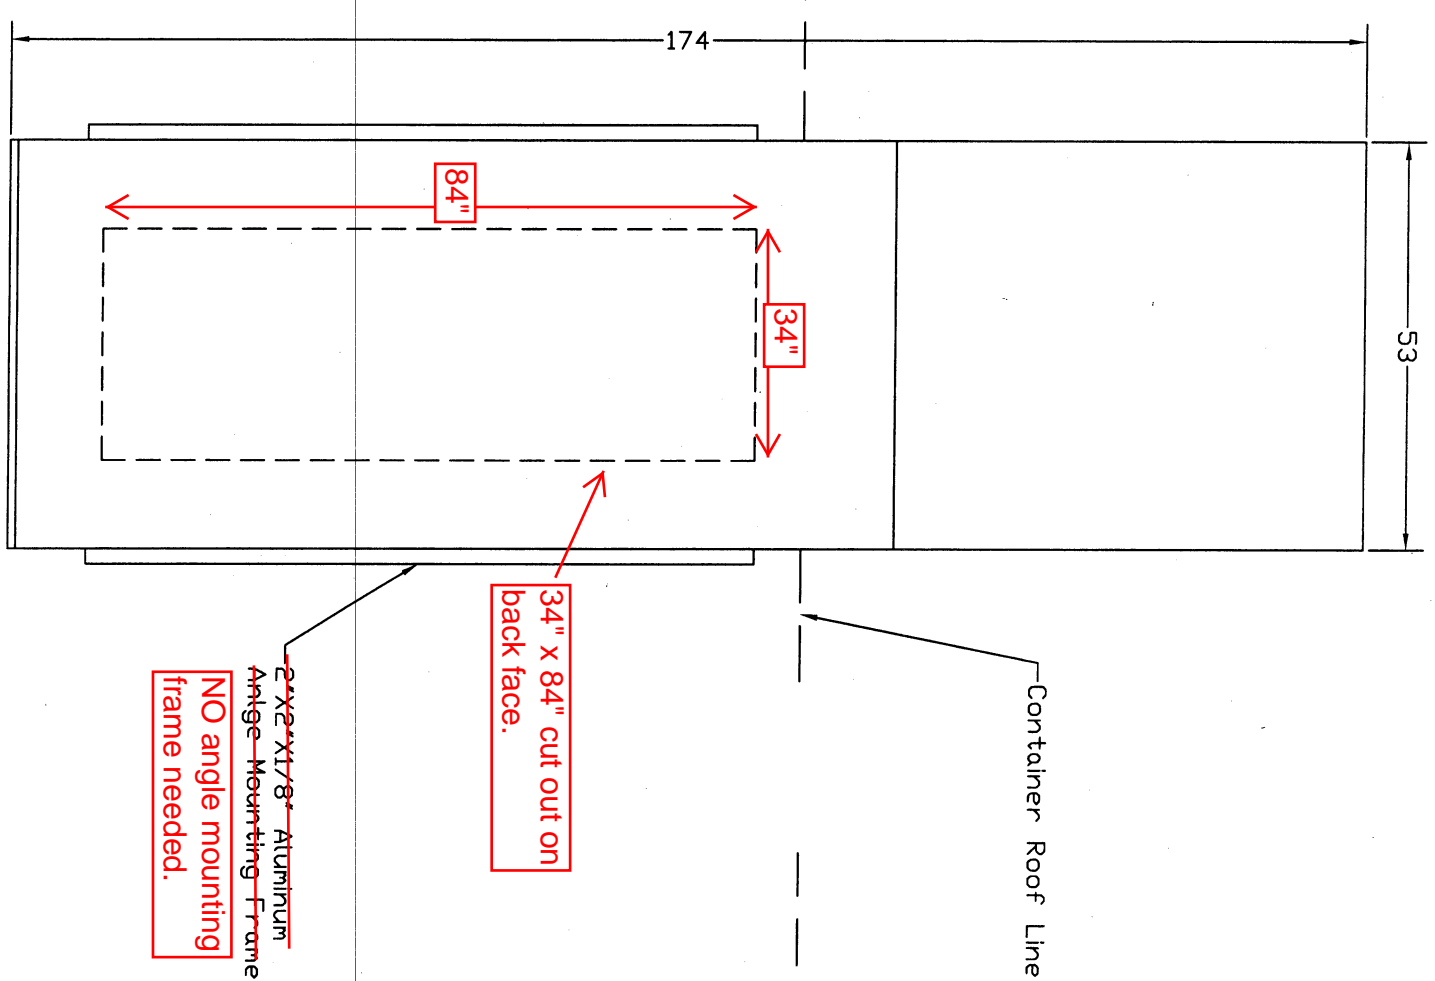


REVISIONS			
REV	DESCRIPTION	DATE	APPROVED

APPROVAL		FLOYD MANUFACTURING	
INITIALS		Ice Cube Project	
TITLE		Snow Hood Intake	
DATE		1 Ea. Required	
JOB NO.	DRAWING NO.	SIZE	DRAWN BY
5wm241ho		D	rah
CUST P.D. NO.	SCALE	DATE	DRAWING TYPE
	1"=1'0"	7/28/03	

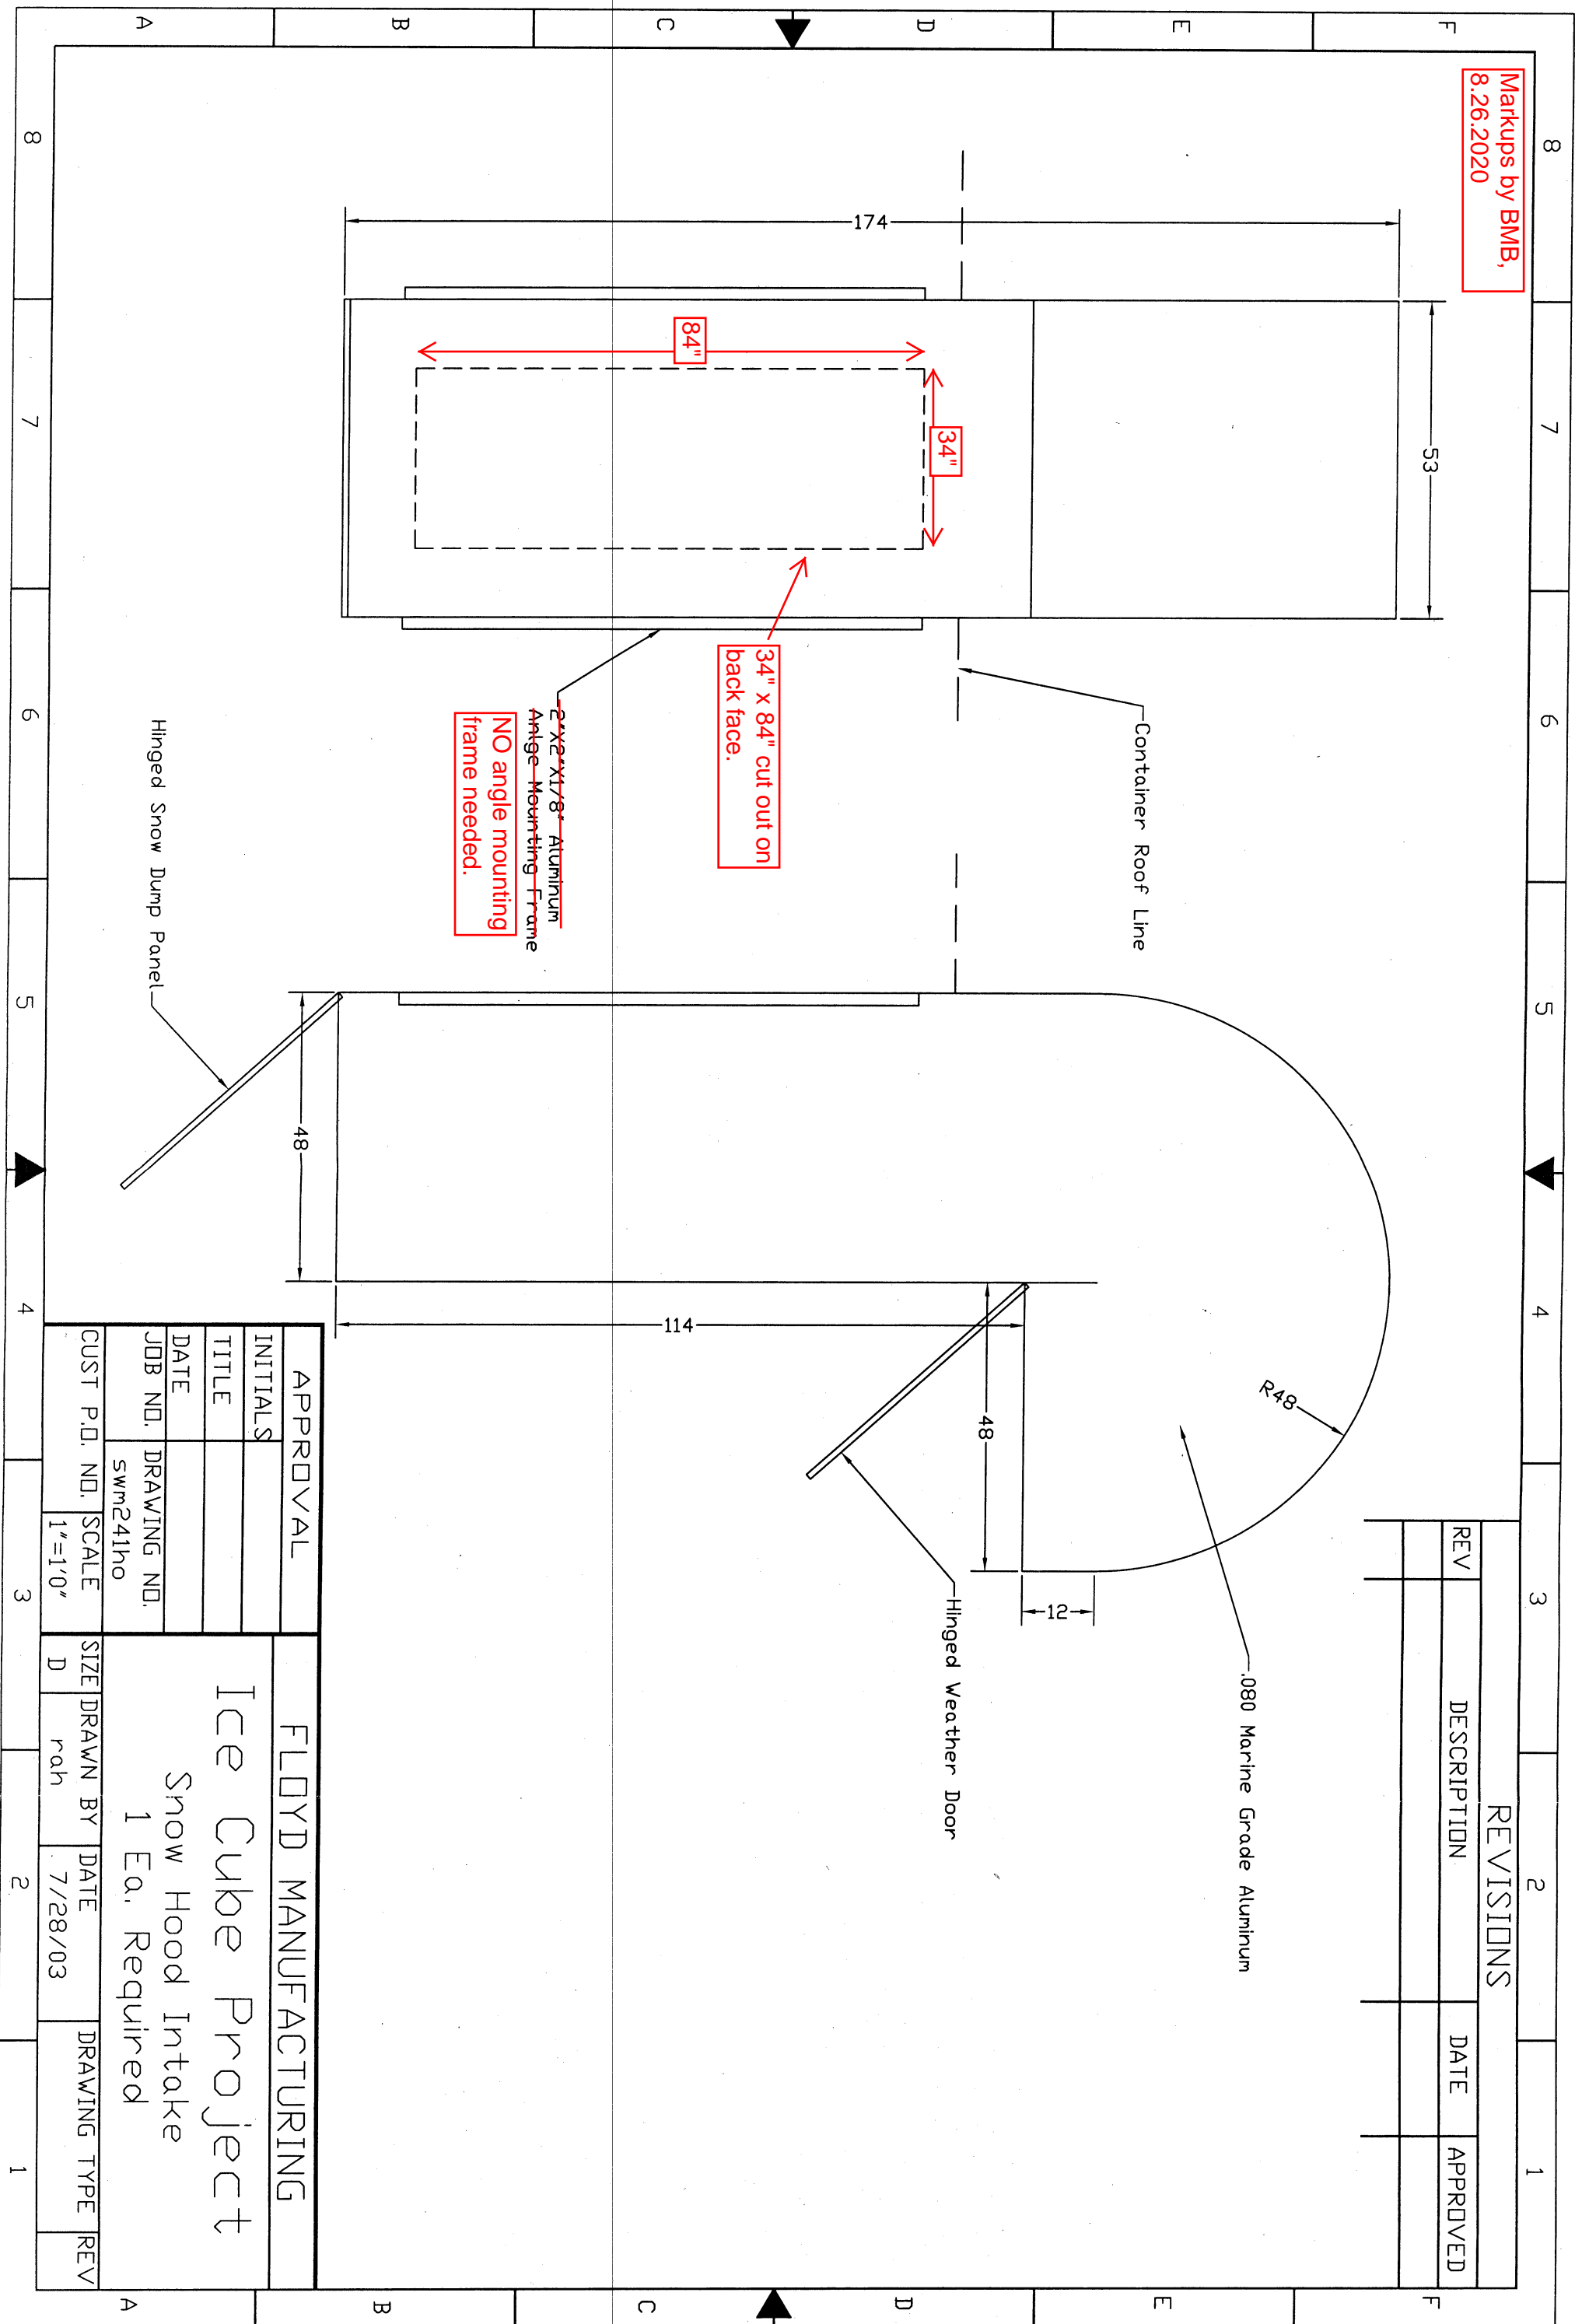

Markups by BMB,
8.26.2020

REVISIONS			
REV	DESCRIPTION	DATE	APPROVED

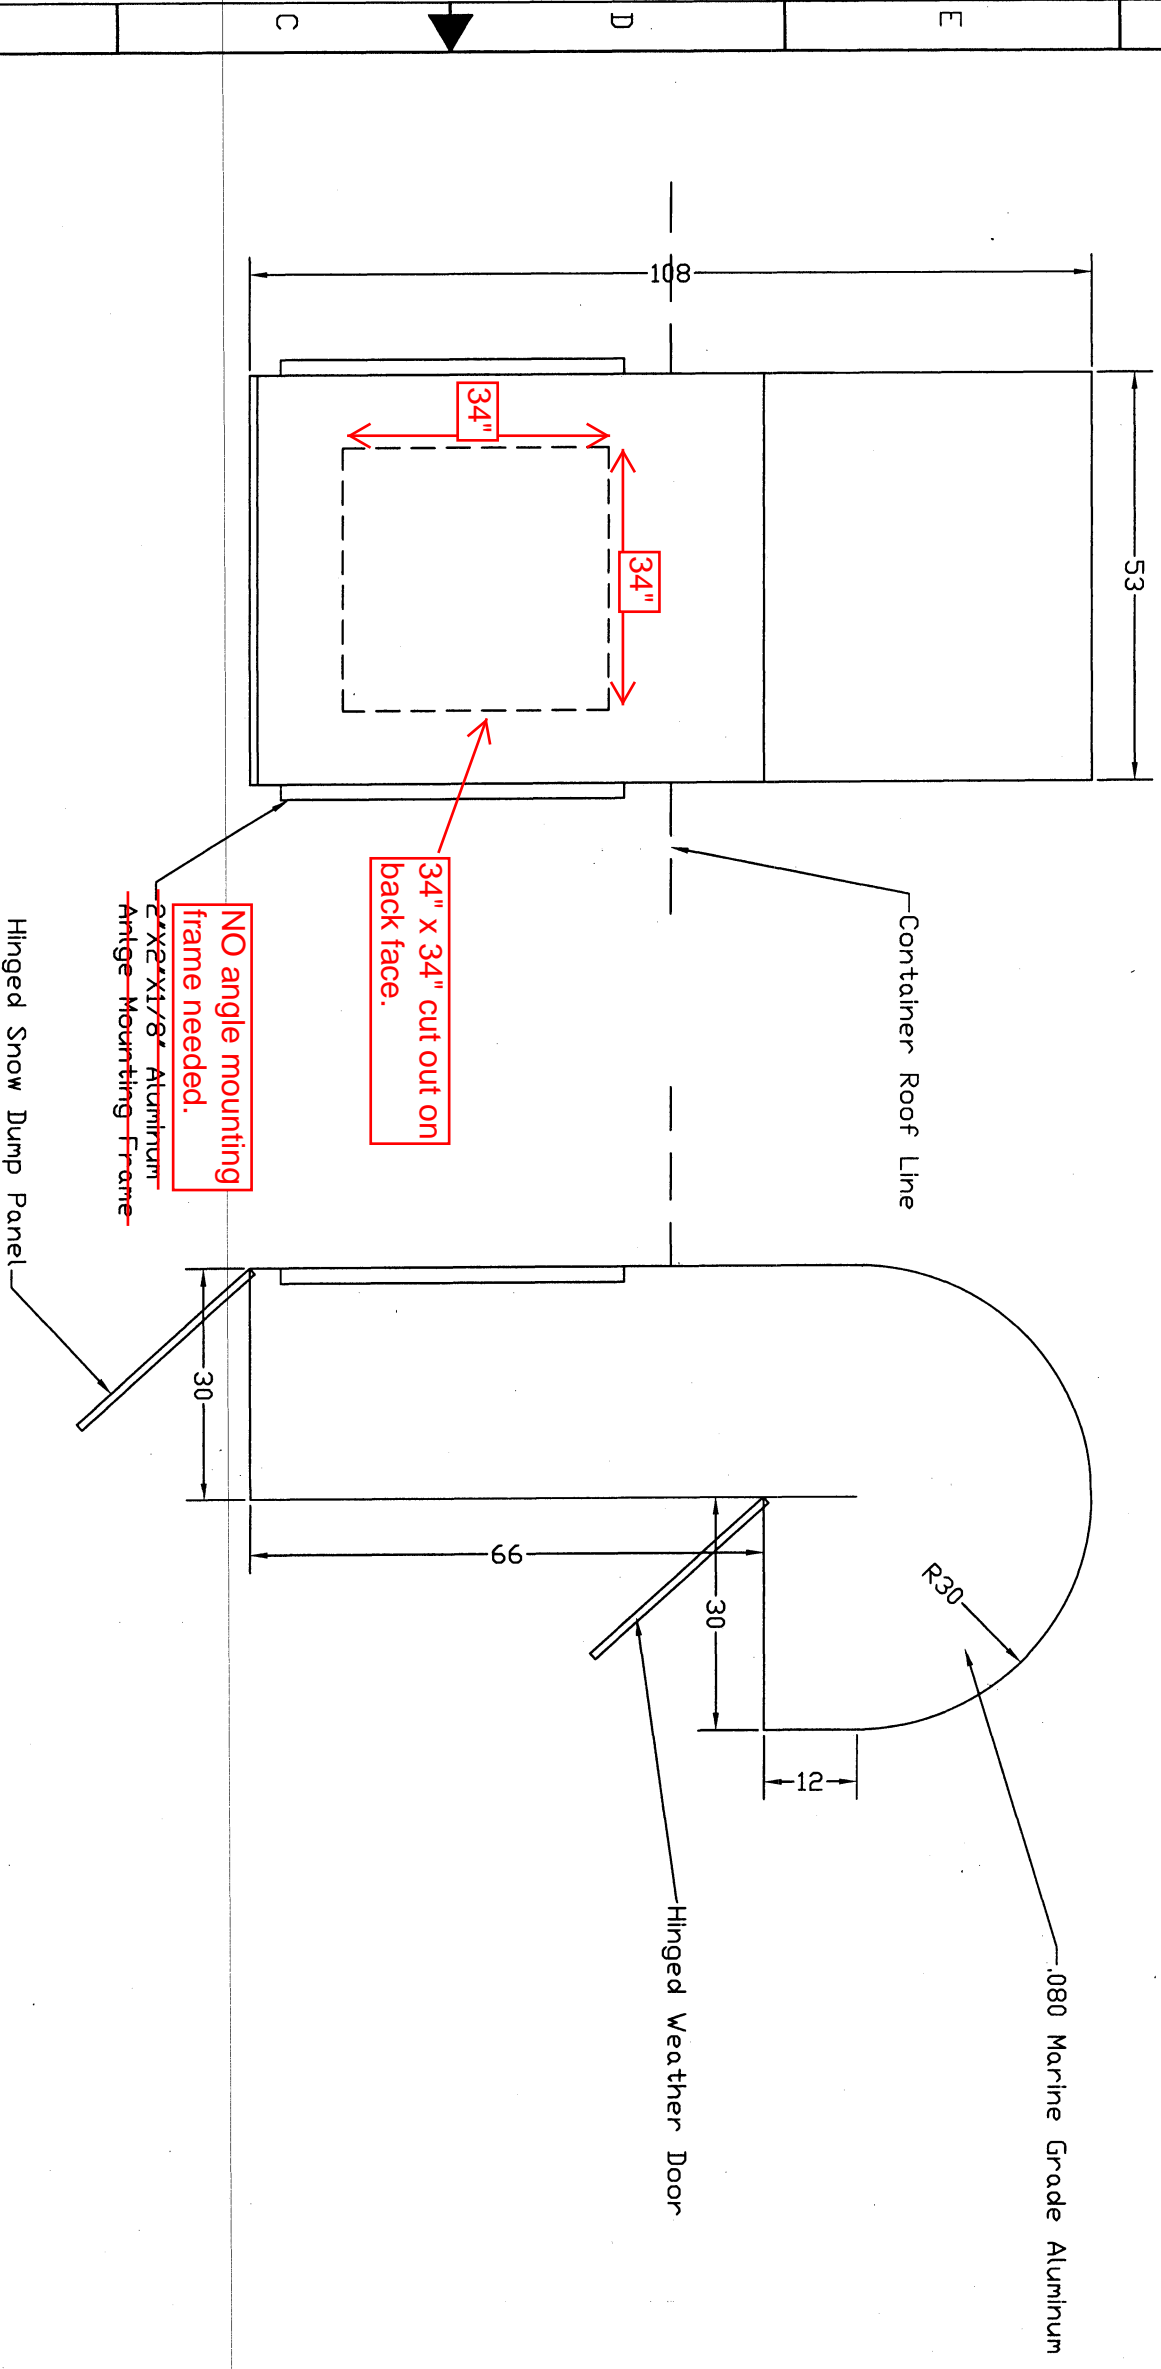

APPROVAL		FLOYD MANUFACTURING				
INITIALS		Ice Cube Project Snow Discharge Hood 2 Ea. Required				
TITLE						
DATE						
JOB NO.	DRAWING NO.					
CUST P.D. NO.	SCALE					
	1"=1'0"	SIZE	DRAWN BY	DATE	DRAWING TYPE	REV
		D	rah	7/28/03		

Grid lines: A, B, C, D, E, F (vertical); 4, 5, 6, 7, 8 (horizontal)